



McGee, James L <james.l.mcgee@wv.gov>

Fwd: Letter to WVDEP and CoR Stormwater Upgrades

1 message

Allison, Keith R <keith.r.allison@wv.gov>

Mon, Sep 27, 2021 at 9:01 AM

To: James L McGee <james.l.mcgee@wv.gov>, John H Hendley <John.H.Hendley@wv.gov>

James,

This needs to be added to the Ran 5/Rockwool Appx site.

Keith

----- Forwarded message -----

From: **Ryan Durrill** <ryan.durrill@rockwool.com>

Date: Fri, Sep 24, 2021 at 1:40 PM

Subject: Letter to WVDEP and CoR Stormwater Upgrades

To: Keith.R.Allison@wv.gov <Keith.R.Allison@wv.gov>, Kim Hawkins <khawkins@ransonwv.us>

Cc: Mark Graves <mark.graves@rockwool.com>, Stacey Phillips <stacey.phillips@rockwool.com>, Kimberly Burgess <kimberly.burgess@rockwool.com>, Gert Fuglsang <gert.fuglsang@rockwool.com>

Good Afternoon Mr. Allison,

Please find the attached letter regarding planned work at the Ranson facility.

Feel free to contact the plant directly if you have any questions.

Thank you,

Ryan

Ryan Durrill

SHEQ Manager – Ranson, West Virginia

ROCKWOOL

665 Northport Avenue

Kearneysville, WV 25430


T 304-830-6464

rockwool.com/westvirginia



2 attachments

 **2021-09-24 Letter to WVDEP on Storm Water - B240(12103542.1).docx**
44K

 **20210920-DEP Exhibit_B240 1 to 1 Scope.pdf**
309K



09/24/2021

Mr. Keith R. Allison

Environmental Inspector
WV Department of Environmental Protection
Division of Water and Waste Management
22288 Northwestern Pk
Romney, WV 26757.

Dear **Mr. Allison**,

The ROCKWOOL, Ranson facility would like to inform you of an improvement project that we will be completing onsite. The work will be completed utilizing under .5 acres of disturbance.

The scope of improvements will include upgrade/repairs of existing storm water pipes in the area of B240 to ensure water is directed efficiently through the appropriate best management practices (BMPs). Absent any objection from you, we expect to begin these improvements on or about 9/28/2021. You are of course welcome to observe.

ROCKWOOL is continuing to evaluate additional improvements and will keep you informed before undertaking any further projects. Please do not hesitate to contact me directly should you have any questions.


Sincerely,

Ryan Durrill
SHEQ Manager

cc: City of Ranson

NOTE:- DERMAN SCOPE WILL PROVIDE RAIN LEADER CONNECTIONS FROM DOWNSPOUTS TO SD MAIN LINES.

Appendix 3

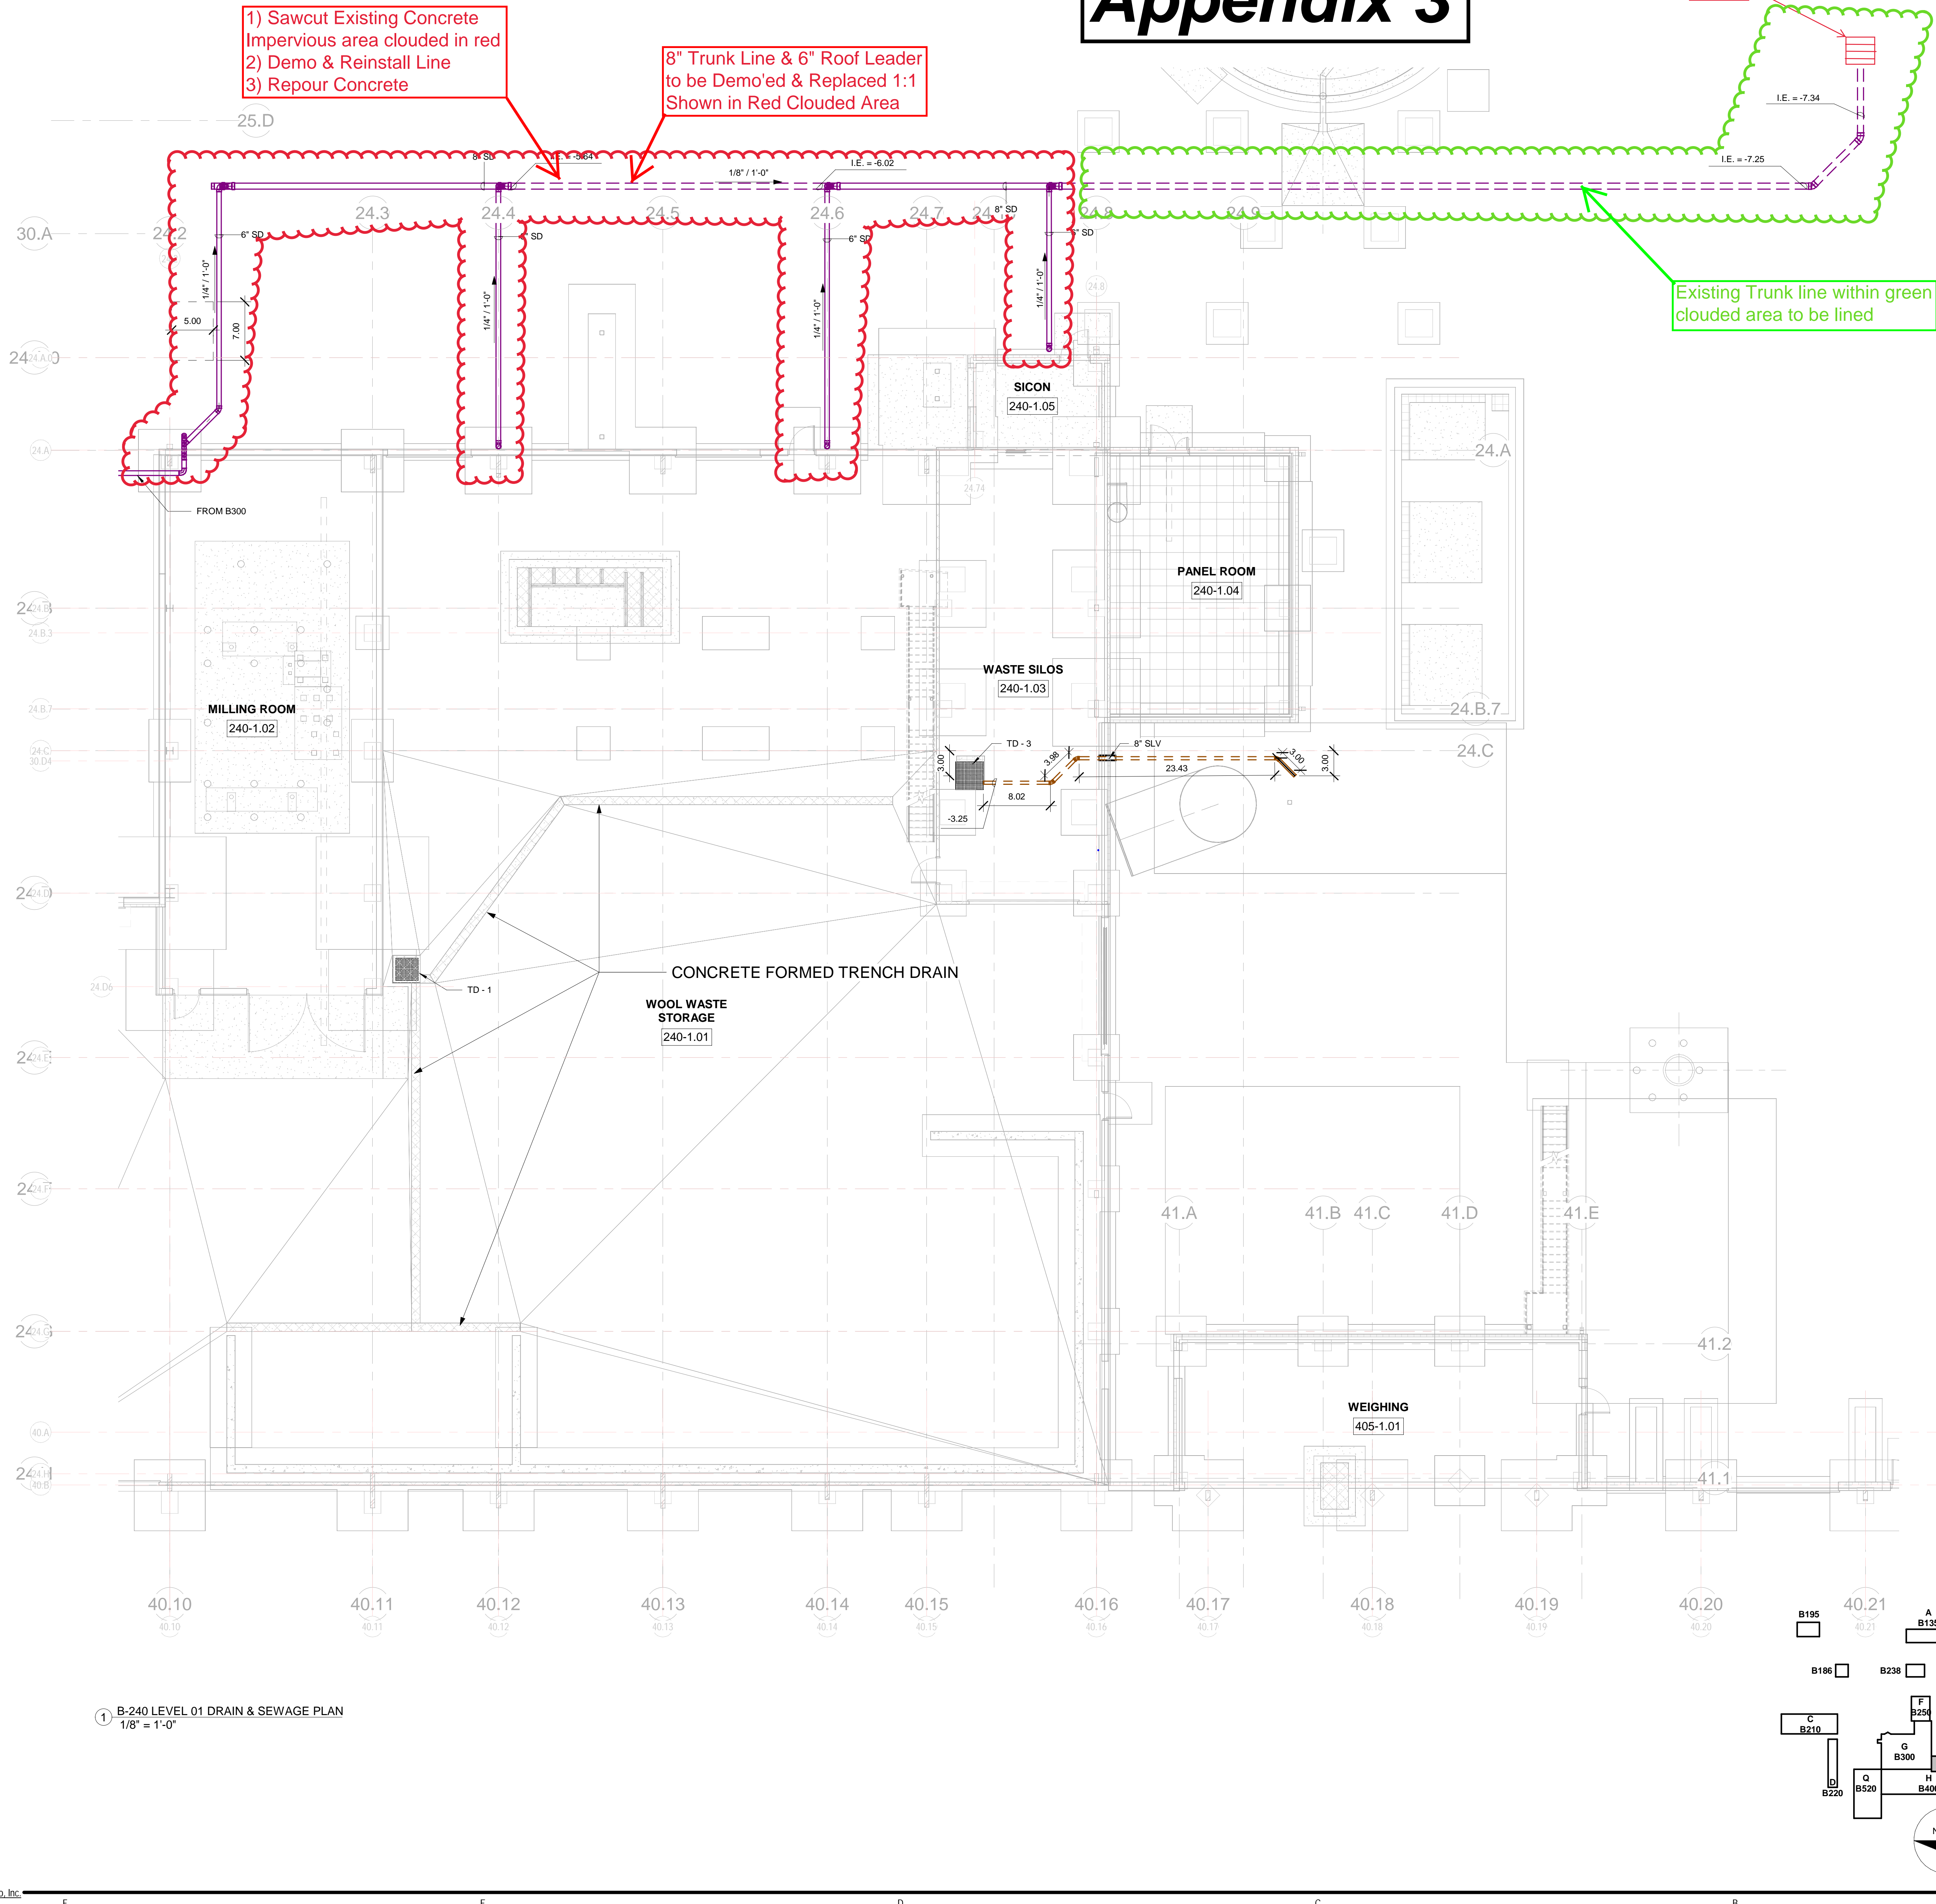


1) Sawcut Existing Concrete
Impervious area clouded in red
2) Demo & Reinstall Line
3) Repour Concrete

8" Trunk Line & 6" Roof Leader
to be Demo'ed & Replaced 1:1
Shown in Red Clouded Area

Existing Trunk line within green
clouded area to be lined

1 B-240 LEVEL 01 DRAIN & SEWAGE PLAN
1/8" = 1'-0"

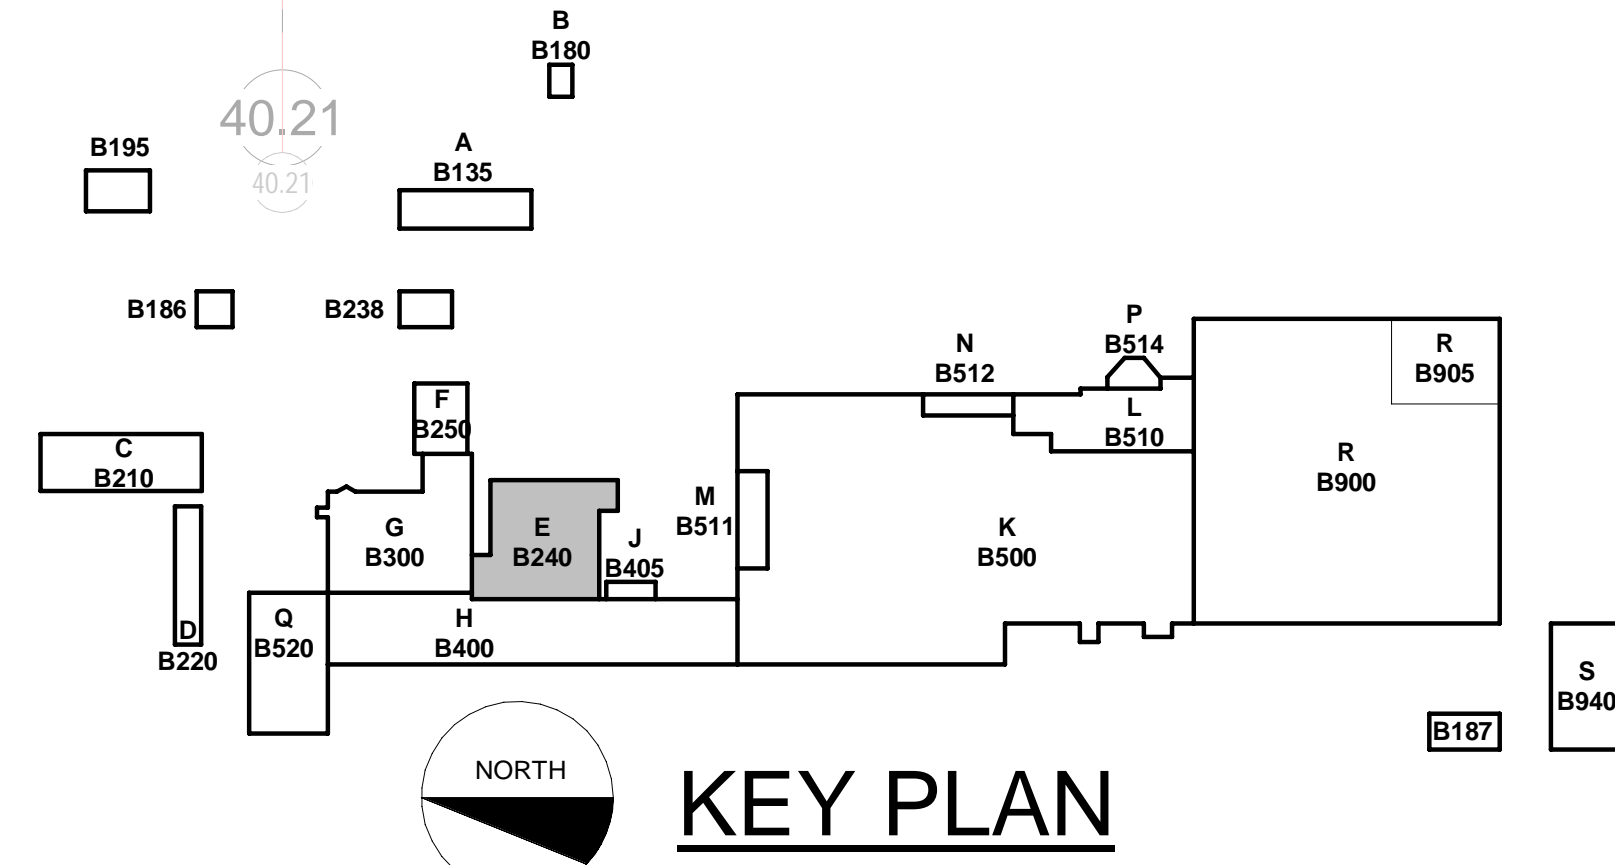

KEY PLAN

DATE PRINTED:
06/11/2020 17:43:35

CLIENT
CLAYCO
THE ART & SCIENCE OF BUILDING
2199 INNERBELT BUSINESS CENTER DRIVE
ST. LOUIS, MISSOURI 63114
PH: 314.423.1010 FX: 314.429.7770

ARCHITECT
FORUM
2199 INNERBELT BUSINESS CENTER DRIVE
ST. LOUIS, MISSOURI 63114
PH: 314.423.1010 FX: 314.429.7770

STRUCTURAL ENGINEER
MECHANICAL ENGINEER
ELECTRICAL ENGINEER
PLUMBING ENGINEER
DERMAN ASSOCIATES
FIRE PROTECTION ENGINEER

DERMAN ASSOCIATES

ROCKWOOL RAN5
ROCKWOOL NORTH AMERICA
665 NORTHPORT AVENUE
RANSON, WEST VIRGINIA 25430

REV.	DESCRIPTION	DATE
---	30% MEPP DESIGN	12.21.18
REV 1	60% MEPP DESIGN	02.07.19
REV 2	90% WORKING COPY	FEB 2019
REV 3	UG PERMIT SET	03.13.19
REV 4	75% MEPP DESIGN	04.04.19
REV 5	UG PERMIT SET 2	04.15.19
REV 6	90% MEPP DESIGN	07.08.19
REV 7	IFC SET	09.16.19
REV 8	ASI-03	12.13.19
REV 9	ASI-05	02.07.20
REV 10	ASI-10	04.10.20
REV 11	ASI-25	11.13.20

REVIEWED: GSK CHECKED: TJE
DRAWING NUMBER:
240-06-6-PE0201
BUILDING NAME
B-240 RECYCLING BUILDING
DRAWING TITLE
B - 240 LEVEL 01 DRAIN & SANITARY PLAN
SHEET NO.
PE0201

Forum Consult.